


PLAT & SURVEY

Survey made June 16, 1966 for Ralph Walker of a part of Lot 8 in Ayers' Outlots in the Northwest 1/4 of Section 8, Town 7 North, Range 4 East, Brady Township, in the Village of West Unity, Williams County, Ohio.

Note also

A. - Placed metal Surveyor's stake.
B. - Found Surveyor's stake of former survey.
C. - Placed large spike in Right-of-way line.

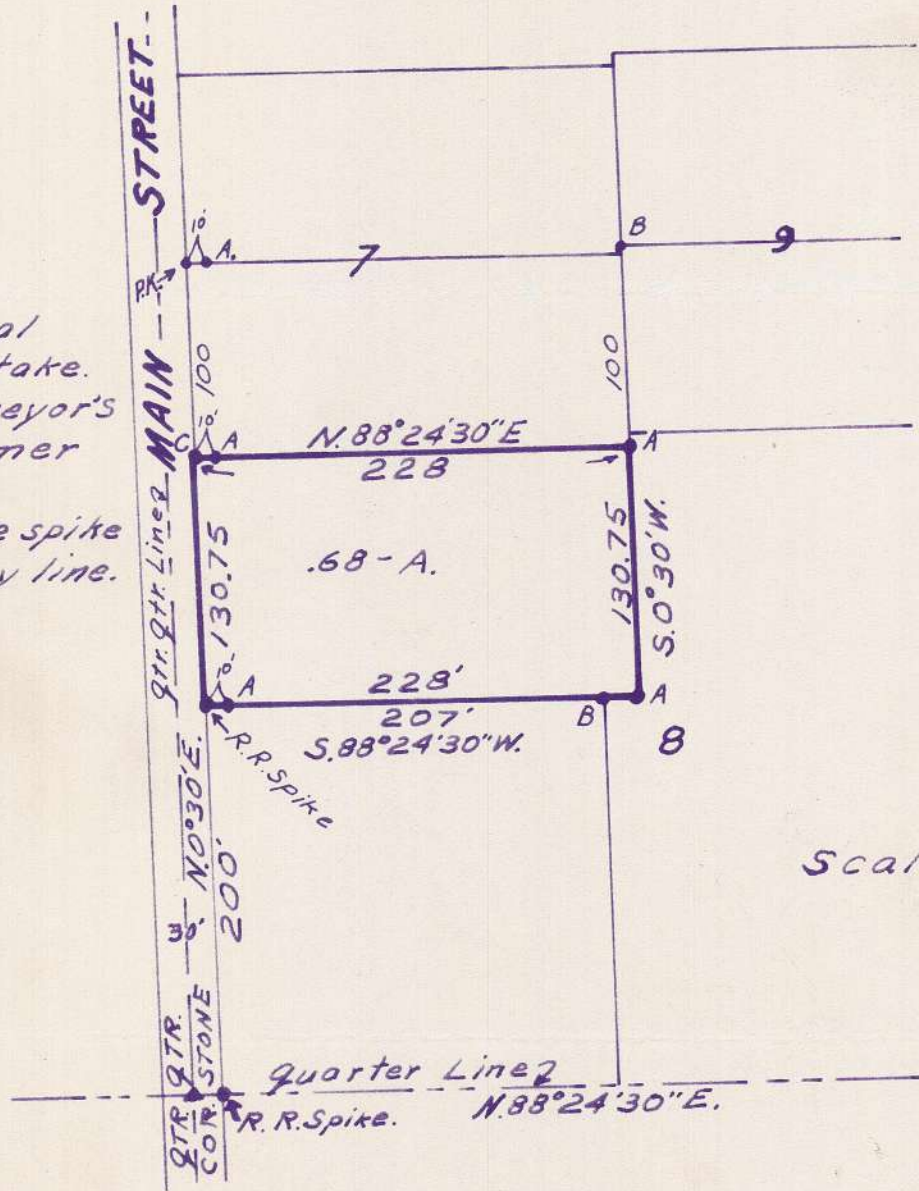

Scale: $1'' = 100'$

Recorded in Vol. ^{4-V}~~2~~ Page ¹⁴¹~~140~~, Record of Surveys, in the Office of
the Williams County Engineer, Bryan, Ohio.

hereby certify the above plat and the survey to be correct to the best of my knowledge.

N. E. Smith